HBR-16 as built Schematic
Completed 2007 by
Lee Craner WB6SSW
from articles first published in
QST October 1959

See accompanying notes on changes from the original design

DECIMAL VALUES OF CAPACITANCE ARE IN μf.; OTHERS ARE IN μμf. EXCEPT AS INDICATED.

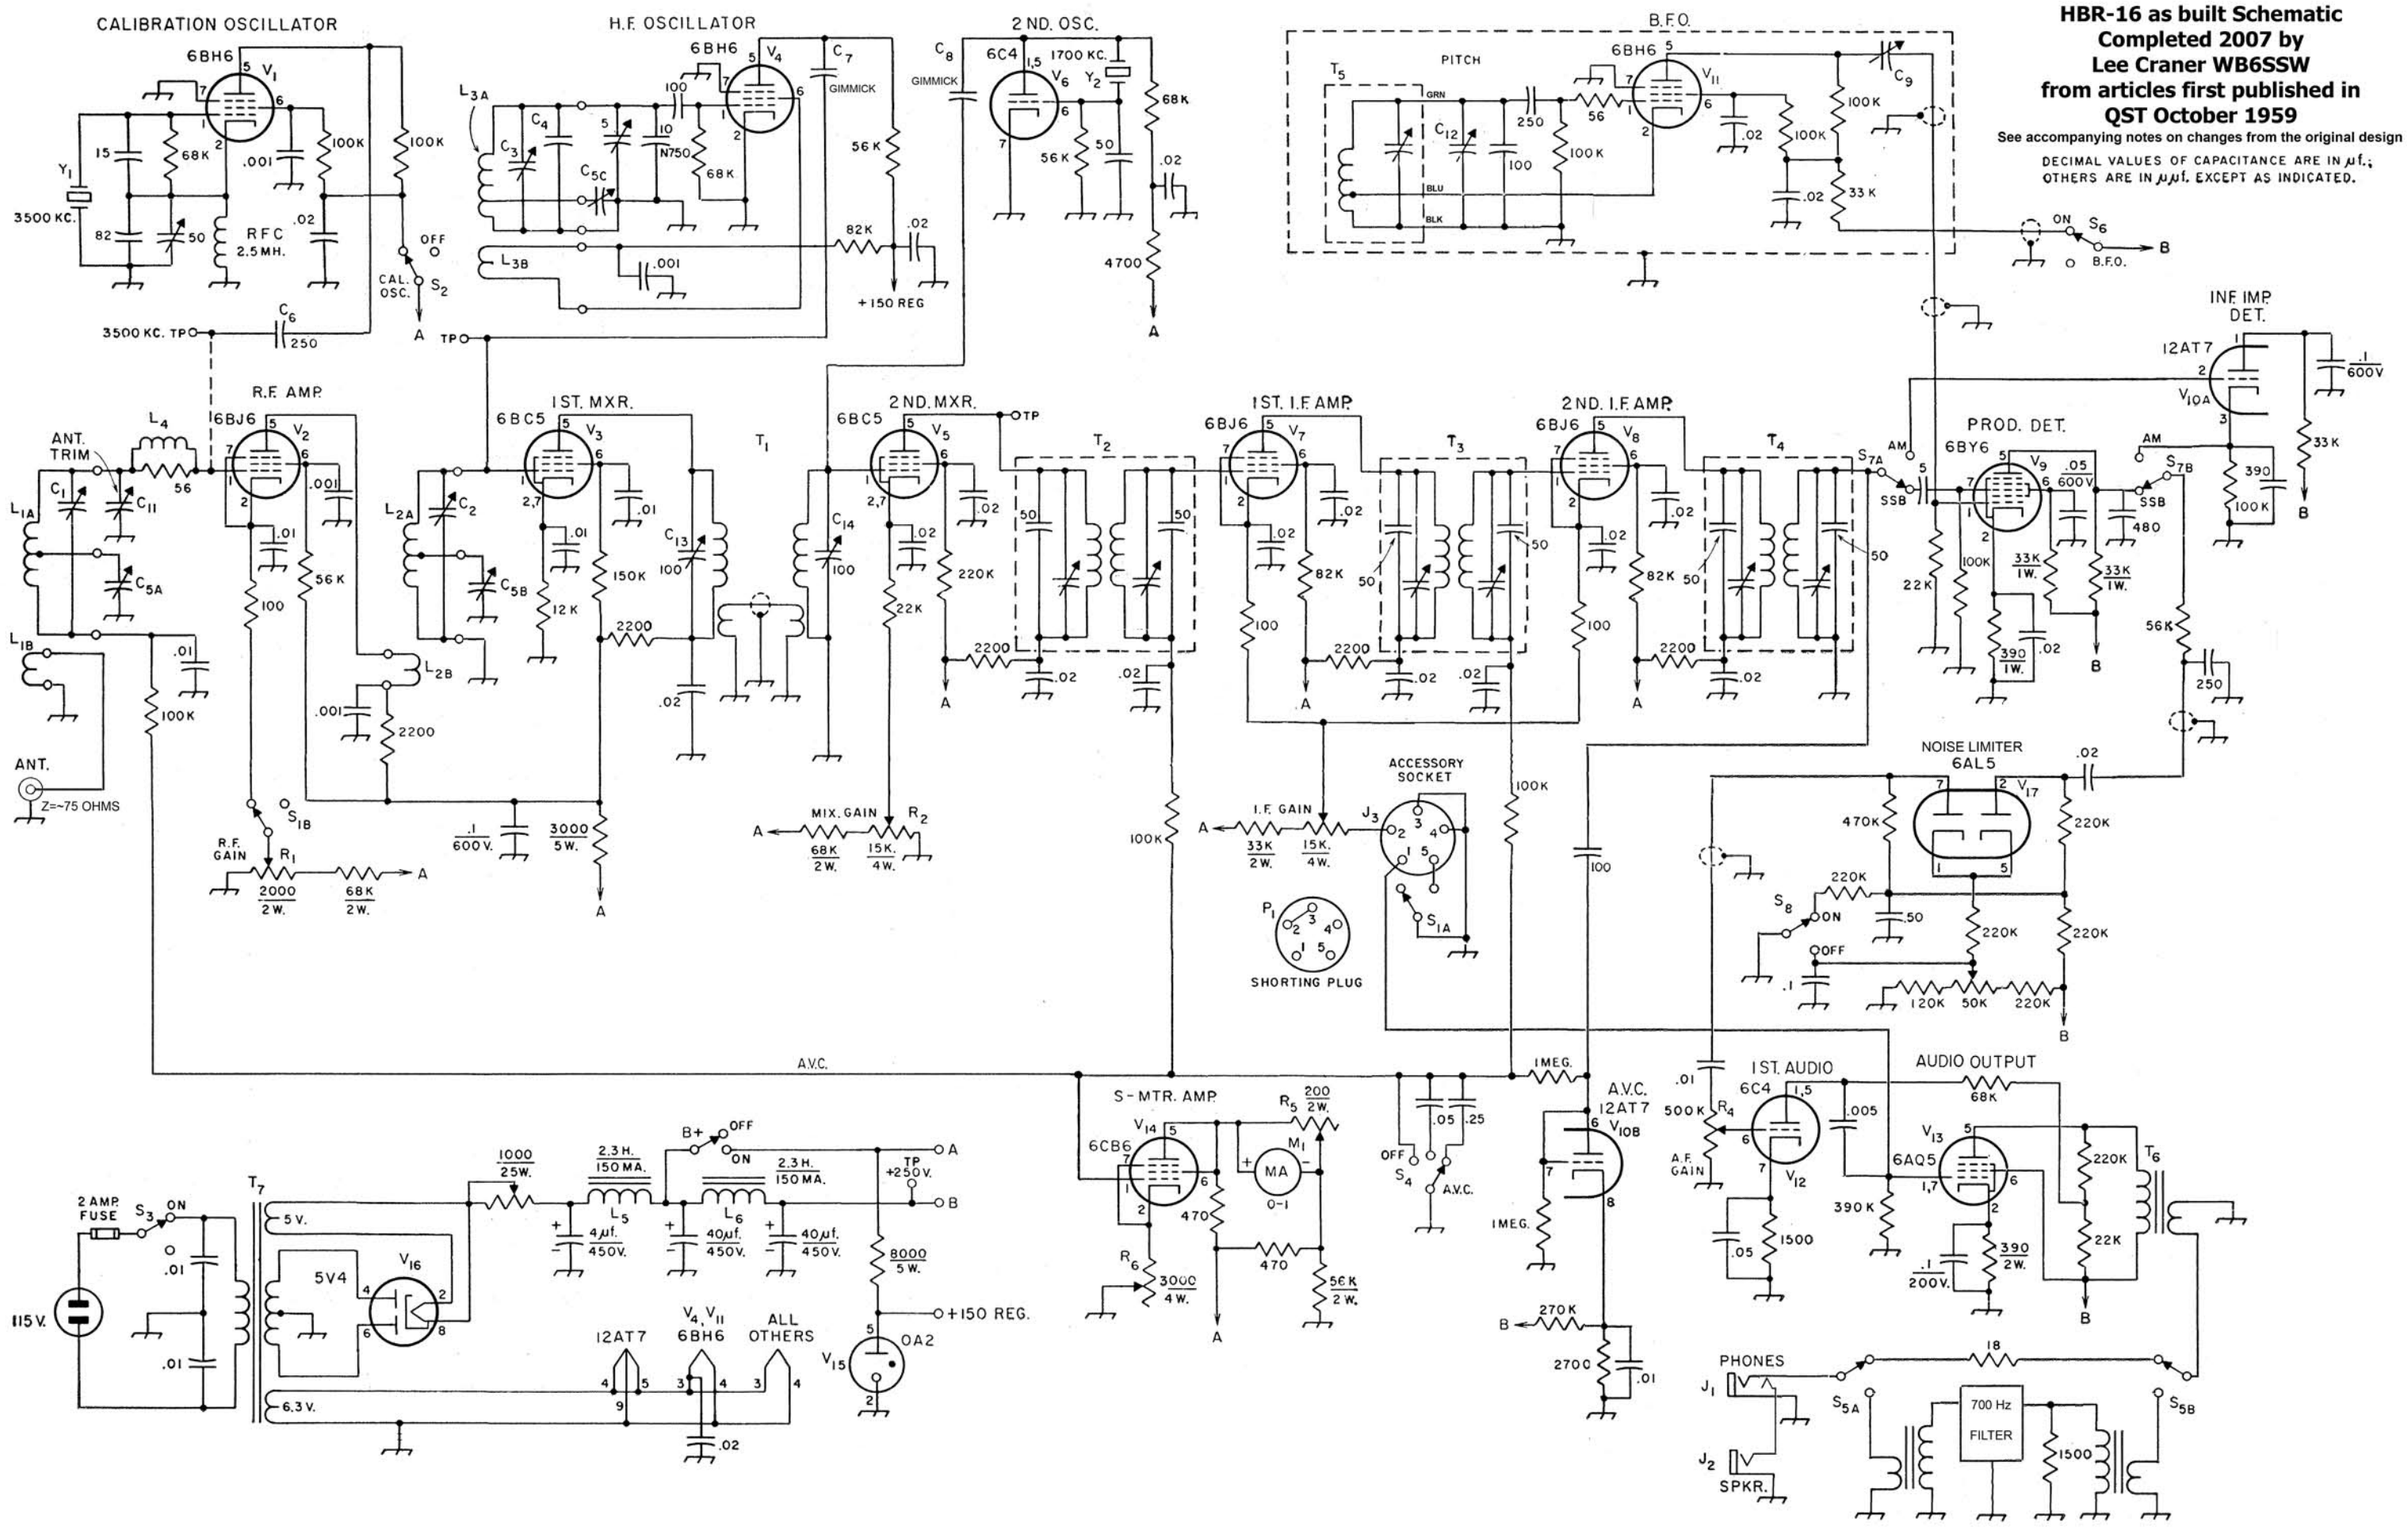

Rev 06-10-10